


Building Units and Group Titles Act 1980 — 1988
 BUILDING UNITS AND GROUP TITLES REGULATIONS 1980

Name of Parcel: ~~BOULEVARD SOUTH~~ PARADISE BOULEVARD SOUTH

Regulation 8(1)
 Sheet No. 2 of 12 Sheets

GROUP TITLES PLAN NO: 70326

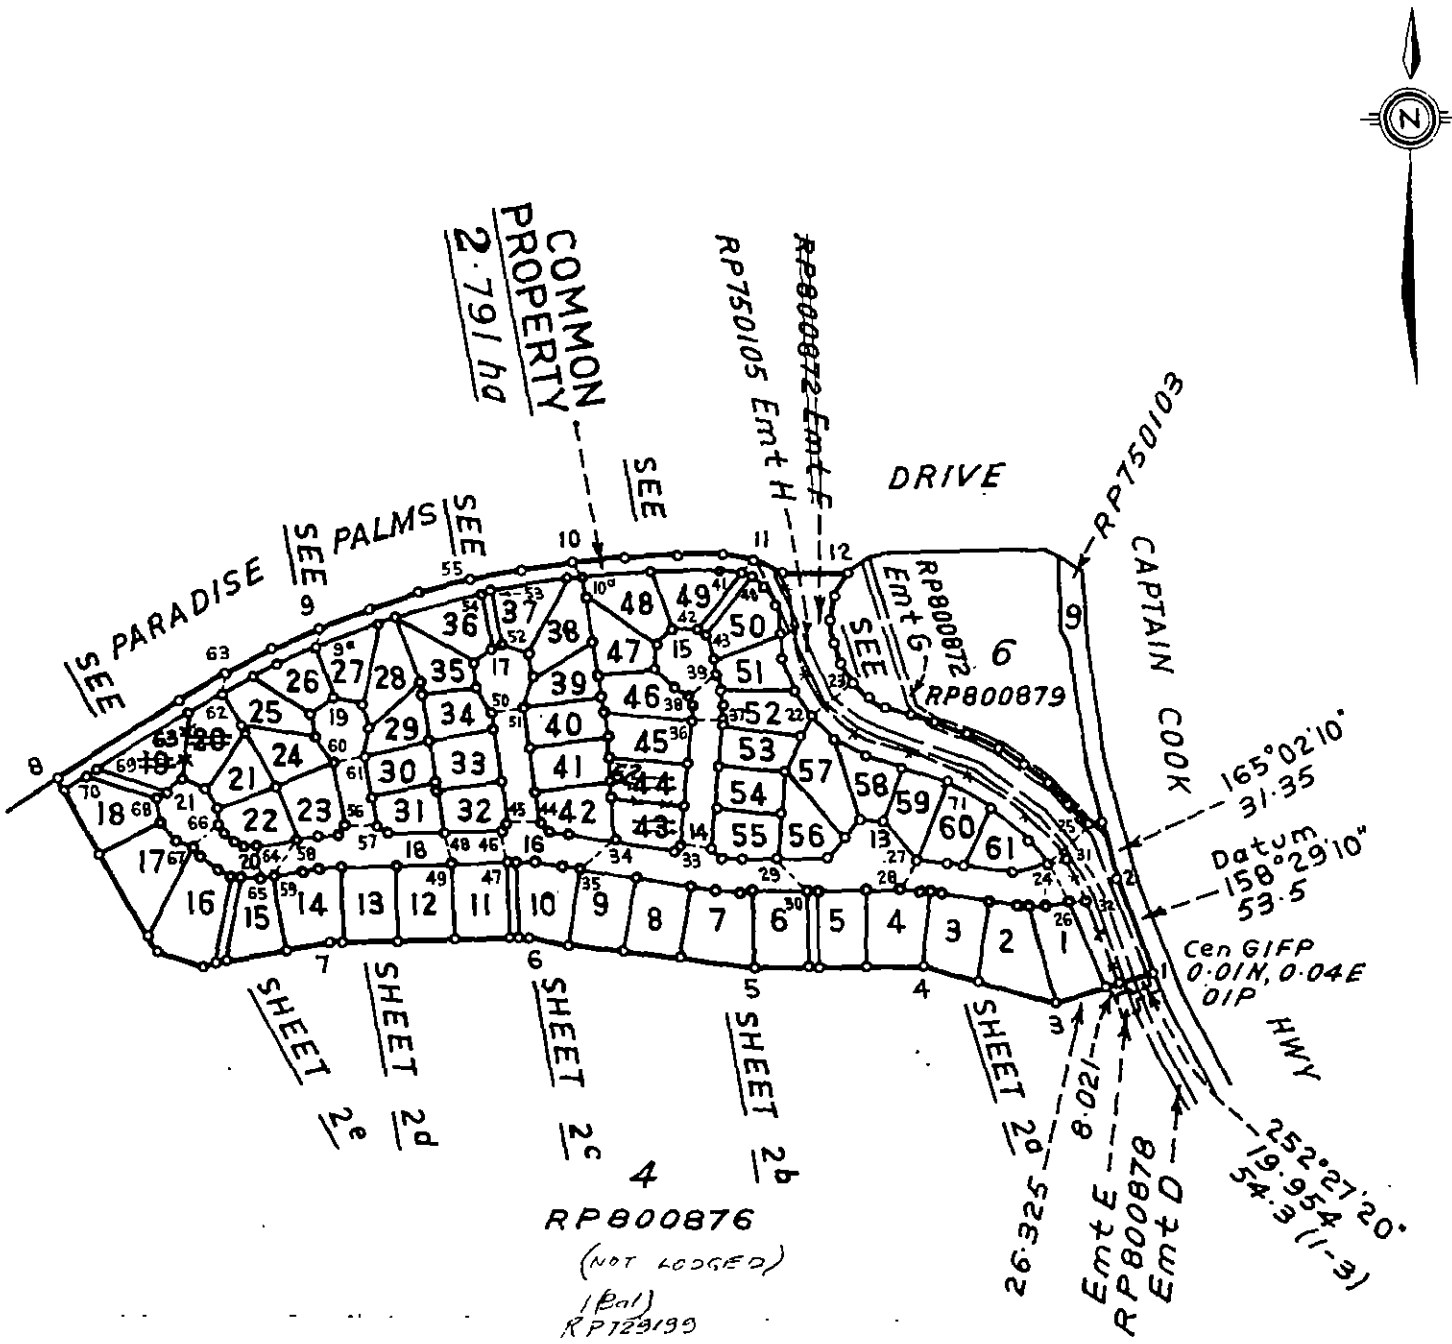

RP800876
 (NOT LODGED)
 1 Pat)
 RP123130

Amendments made to Unit Nos. 43 & 44 in accordance with G.T.P. of Amalgamation No. 70355 this 30th day of July 1991.

Amendments made to Unit Nos. 19 & 20 in accordance with G.T.P. of Amalgamation No. 70363 this 7th day of October 1991.

DISTRICT REGISTRAR OF TITLES
 SIGNATURE OF REGISTERED PROPRIETOR:

SCALE: 1:4000



Amendments in red made pursuant to Section 112 (1A)
 District Registrar of Titles
 N. C. W. Senior Date 7 11 90
 Senior Plan Examiner

Dean Wells
 ATTORNEY - GENERAL
 DATED: 12-6-90

A. H. Schwartz A/Shire Clerk
 XX&WH
 COUNCIL OF THE SHIRE OF MULGRAVE

Building Units and Group Titles Act 1980 — 1988
 BUILDING UNITS AND GROUP TITLES REGULATIONS 1980

Name of Parcel: ~~BOULEVARD SOUTH~~ PARADISE BOULEVARD SOUTH


Regulation 8(1)
 Sheet No. 2 of 12 Sheets

GROUP TITLES PLAN NO. 70326

Reference Marks

Stn	To	Remks	Bearing	Dist
7	OIP	RP750105	170°22'	1.75
9	O Nail	"	337°20'	7.504
18	Nail in	kerb	285°03'	15.11
19	"	"	142°28'	5.615
48	"	"	179°06'30"	4.434
49	"	"	314°28'	6.09

Peg.pld at all new corners

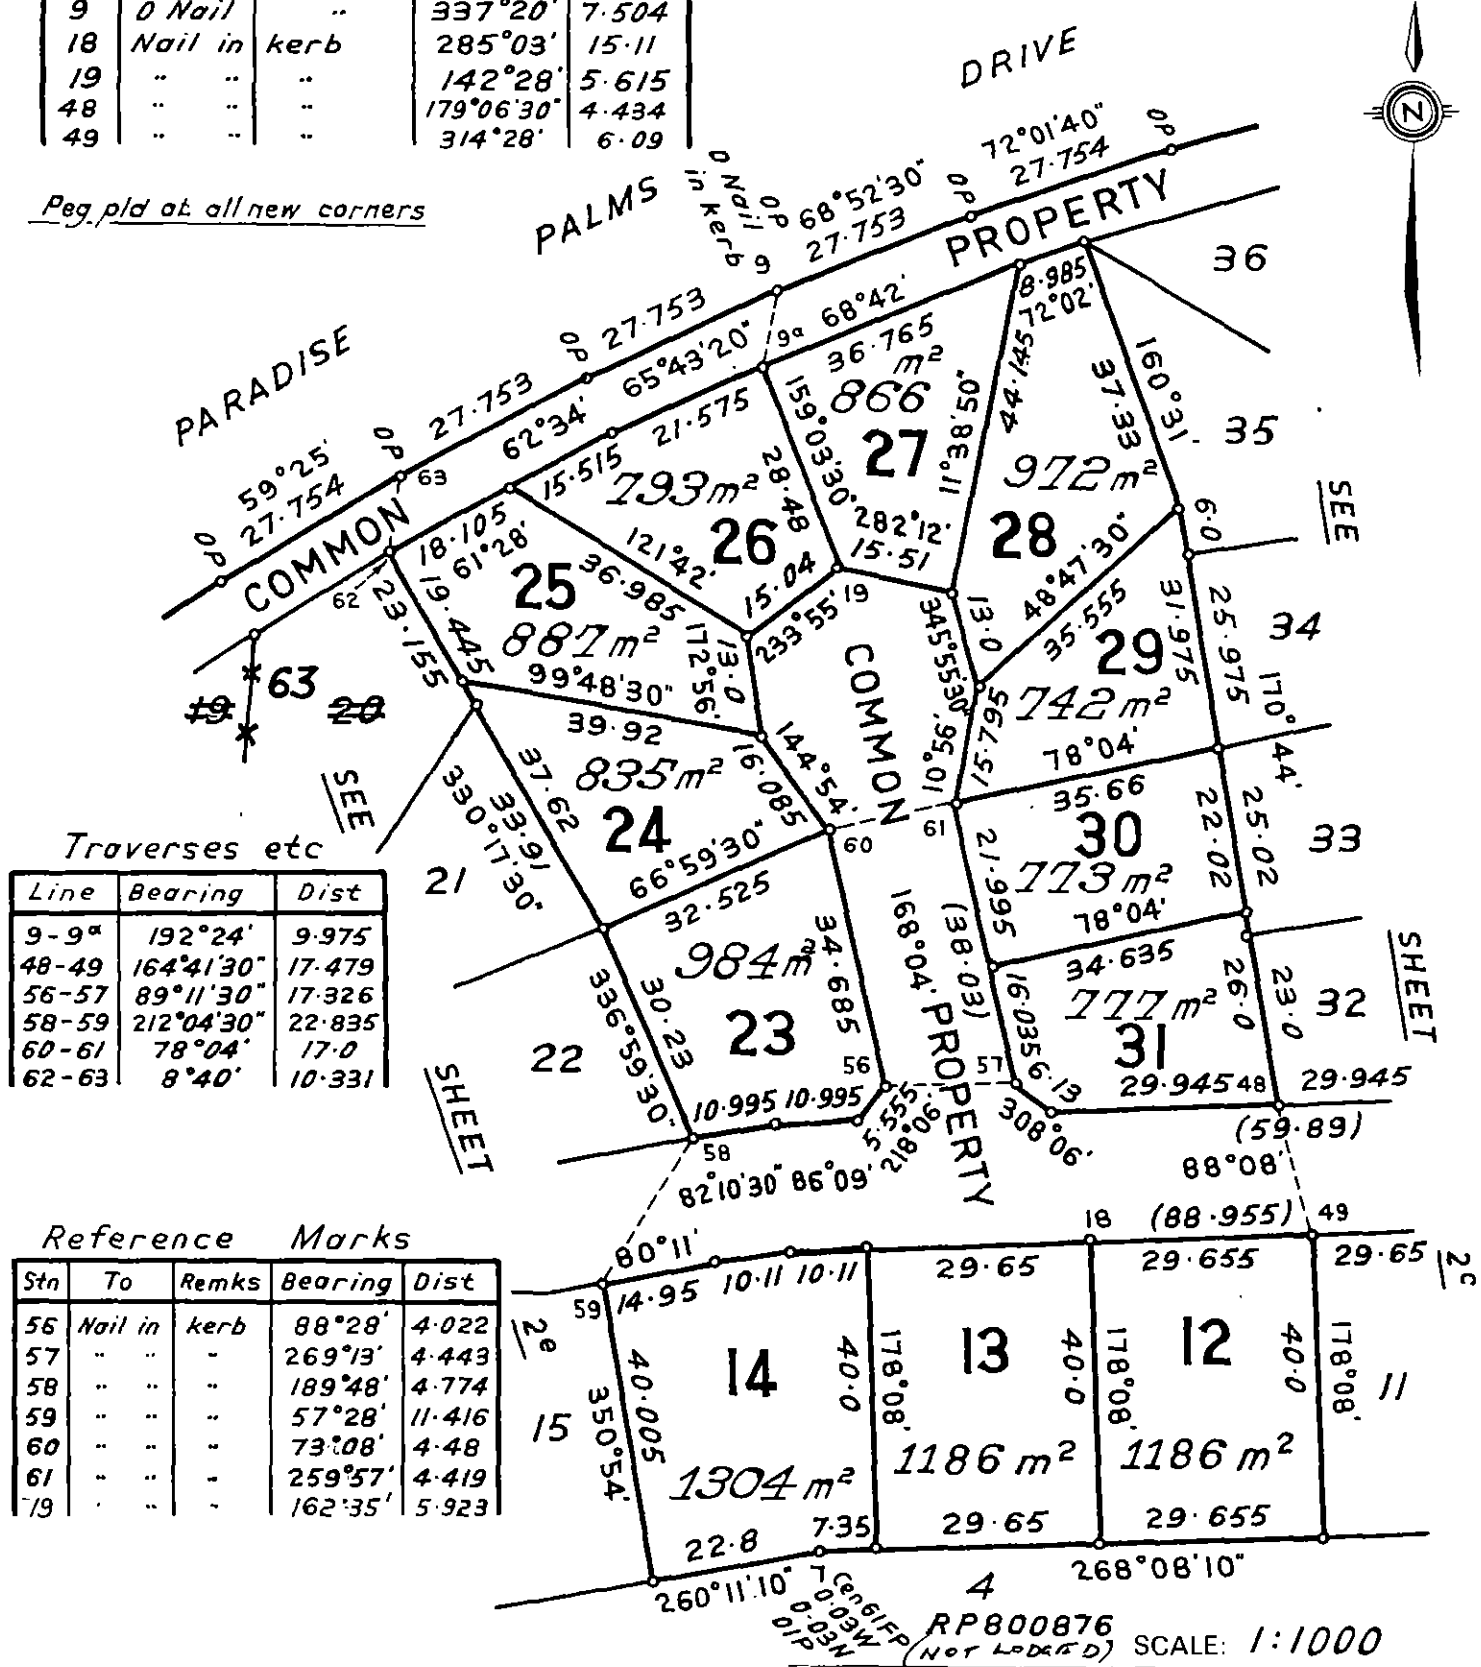

Traverses etc

Line	Bearing	Dist
9-9 ^a	192°24'	9.975
48-49	164°41'30"	17.479
56-57	89°11'30"	17.326
58-59	212°04'30"	22.835
60-61	78°04'	17.0
62-63	8°40'	10.331

Reference Marks

Stn	To	Remks	Bearing	Dist
56	Nail in	kerb	88°28'	4.022
57	"	"	269°13'	4.443
58	"	"	189°48'	4.774
59	"	"	57°28'	11.416
60	"	"	73°08'	4.48
61	"	"	259°57'	4.419
79	"	"	162°35'	5.923

SIGNATURE OF REGISTERED PROPRIETOR:



Dean Wells
 ATTORNEY - GENERAL
 DATED: 12-6-90

[Signature] Shire Clerk
 XXXX

COUNCIL OF THE SHIRE OF MULGRAVE